



ELEVACÃO VISTA EXTERNA

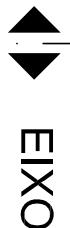


PV-07

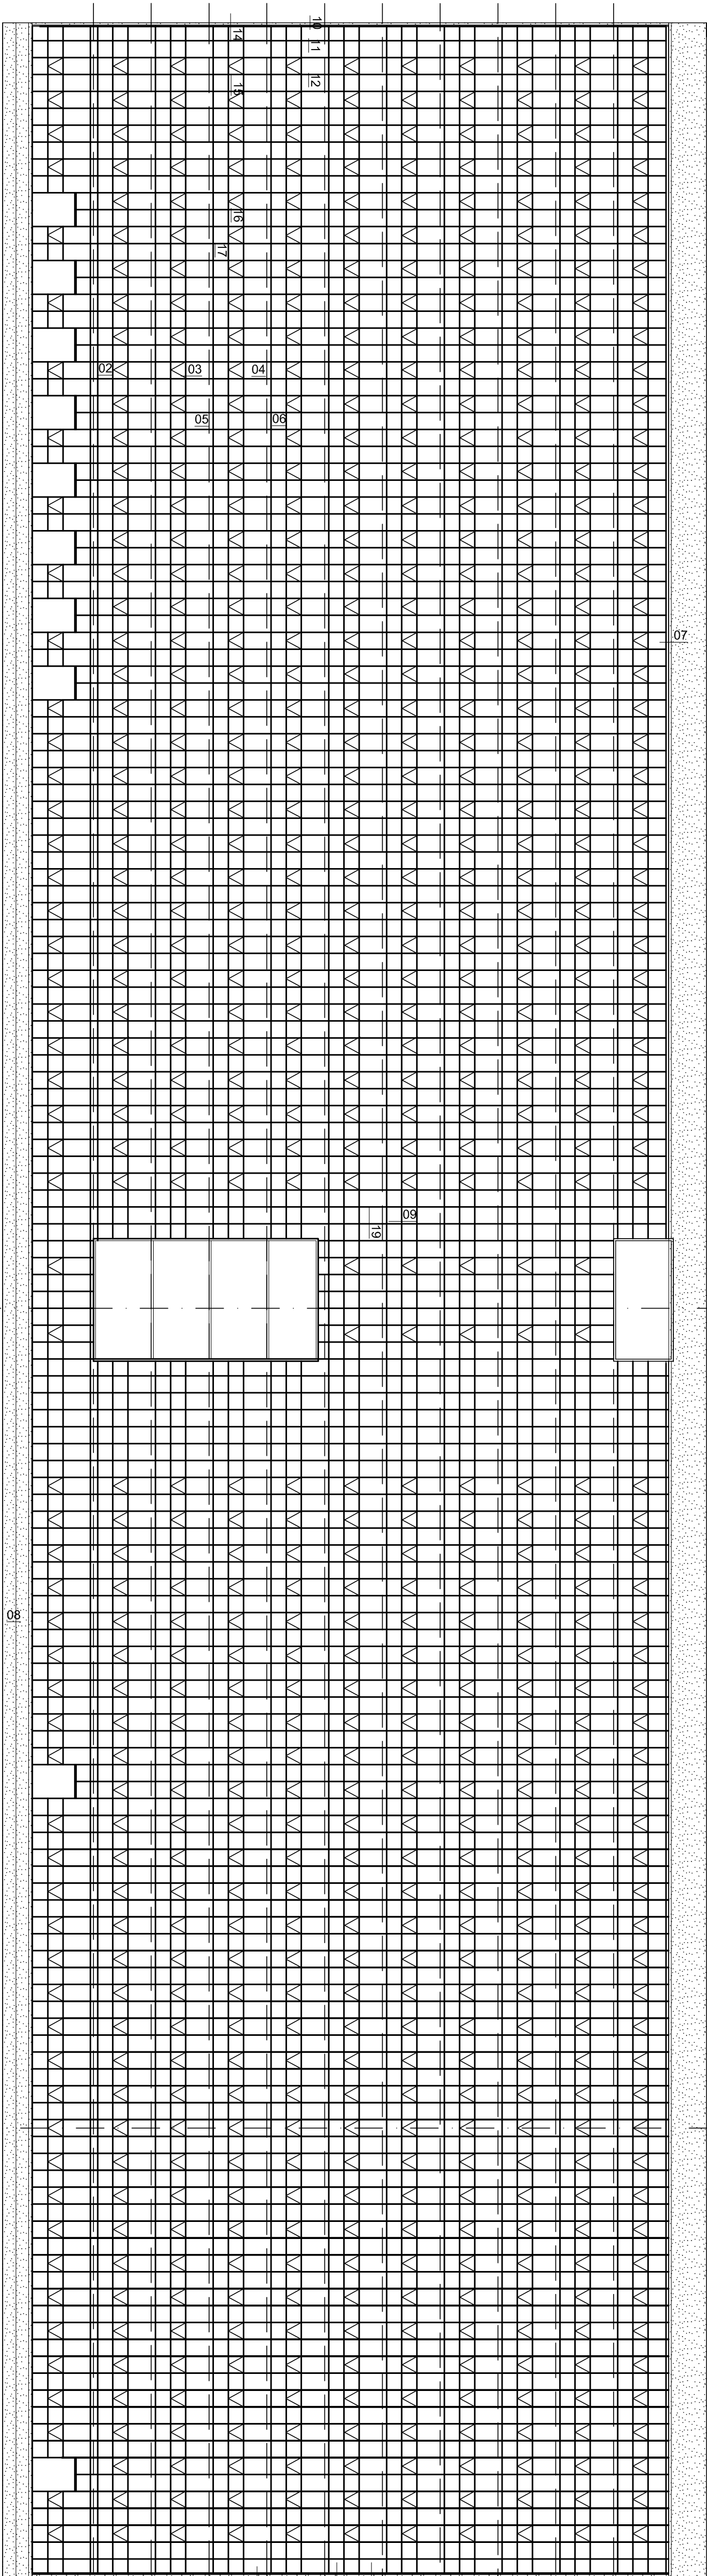

ELEVACÃO - Bloco D




Planta Baixa do Andar Tipo

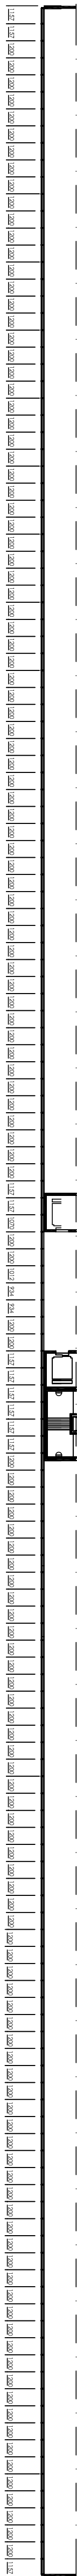


A


Corte AA

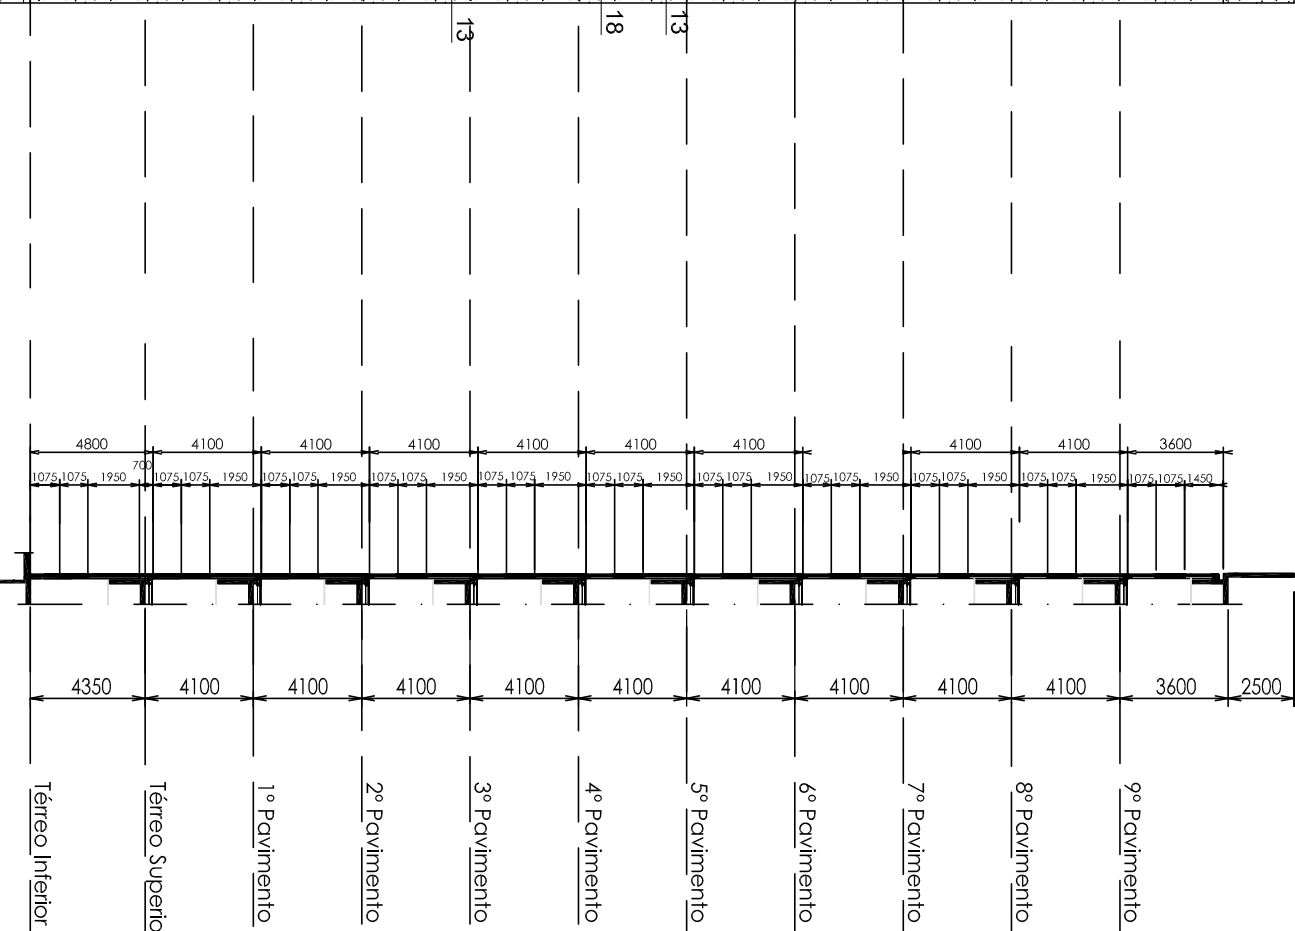


Planta Baixa do 3º Pavimento

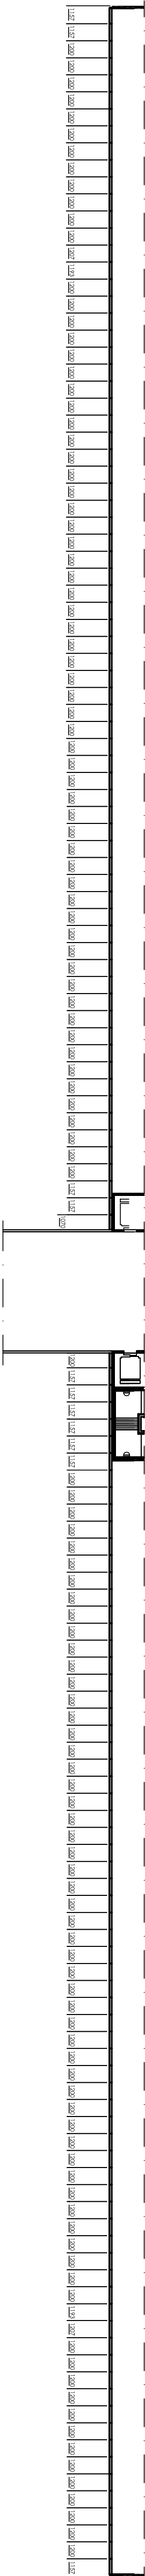


Planta Térreo Superior

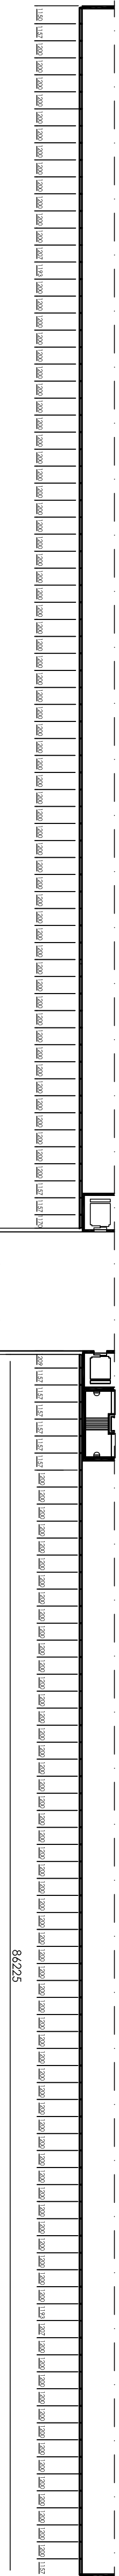

Planta Térreo Inferior

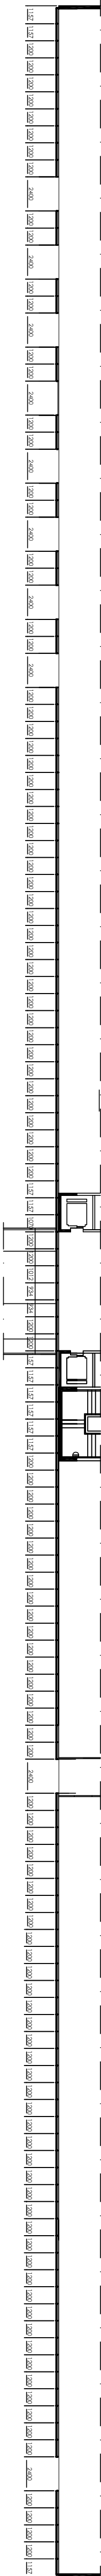

TOTAL QUADROS - BLOCO D SUL			
ARG(m²)	ALT(mm)	QUANT.	ÁREA (m²)
1157	4880	11	61,0896
1157	4100	99	469,6263
1157	3600	11	45,8172
1200	4880	116	668,16
1200	4100	1208	5943,36
1200	3600	132	570,24
1070	4880	1	5,136
1070	4100	9	39,483
1070	3600	1	3,852
934	4100	10	38,294
934	4880	2	8,9664
1012	4100	5	20,746
1012	4880	1	4,8576
1200	2880	20	67,2
TOTAL			7.946,83

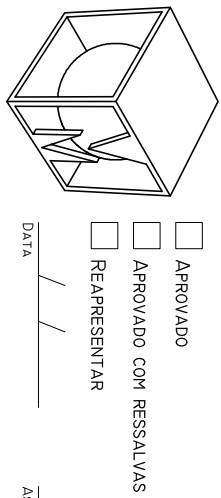

APROVADO COM RESERVA  
REPRESENTAR

200

01	10/03/2015	Tratado Final	Tratado
02	04/07/2015	Revisão Final	Revisão
03	10/03/2015	Revisão Final	Revisão



JUSTIÇA FEDERAL  
TRF 1ª Região  
PROJETO AS BUILT

TÍTULO	PROJETO AS BUILT	PROJETO AS BUILT	PROJETO AS BUILT
TPQ-PV-07	PROJETO AS BUILT	PROJETO AS BUILT	PROJETO AS BUILT
1200	04/07/2015	Revisão	Revisão
1200	04/07/2015	Revisão	Revisão
1200	04/07/2015	Revisão	Revisão